

THE AUTO SUPERSTORE

STORE # 7126 1000 S. FLOWER STREET BURBANK, CA 91502

SINGLE LEVEL OPEN PARKING STRUCTURE

CONTACTS:

THE AUTO SUPERSTORE 12800 Tuckahoe Creek Parkway

Richmond, VA 23238 Phone (804) 747-0422 Fax (804) 935-6146

Contact: Josh Abig [josh_abig@carmax.com]

Contractor & Lusardi Construction Company Project Contact: 1570 Linda Vista Dr. San Marcos, CA 92078 Phone (760) 744-3133 x 1310

> Fax (760) 744-5132 Contact: Mike Ramsey [mramsey@lusardi.com]

1053 Tenth Ave. San Diego, CA 92101 Phone (619) 238-3811 Fax (619) 238-0442 Contact: Eric Davy [mail@davyarchitecture.com]

Civil Engineer: Moran Consulting Corporation

Davy Architecture, Inc.

4500 E. Pacific Coast Highway, Suite 210 Long Beach, CA 90804 Phone (562) 340-4671

Fax (562) 340-4680 Contact: Cesar Moran [cmoran@moran-corp.com]

PROJECT DATA

PROJECT ADDRESS: 1000 S. FLOWER ST BURBANK, CA 91502 APN: 5624-022-009 ZONING: M-2 GENERAL INDUSTRIAL LOT AREA: 4.64 AC. (202,036 s.f.)

BUIL	DING AF	REAS (s.f.)		
EXISTING		PROPOSED		TOTAL
SHOWROOM/SALES	11,121	PARKING GARAGE	GE 28,999 00.750	
PARKING GARAGE	40,632			80,752
CARWASH	1,109			
SERVICE AREA	6,358			42,311
UPPER LEVEL 34,844				
				123,063
	EXISTING SHOWROOM/SALES PARKING GARAGE CARWASH SERVICE AREA	EXISTING SHOWROOM/SALES 11,121 PARKING GARAGE 40,632 CARWASH 1,109 SERVICE AREA 6,358	SHOWROOM/SALES 11,121 PARKING GARAGE PARKING GARAGE 40,632 CARWASH 1,109 SERVICE AREA 6,358	EXISTING PROPOSED SHOWROOM/SALES 11,121 PARKING GARAGE 28,999 PARKING GARAGE 40,632 CARWASH 1,109 SERVICE AREA 6,358

FLOOR AREA RATIO (FAR): (11,121+6,358+1,109=18,588) => (18,588 / 202,036 = 0.092) LOT COVERAGE: 80,752 / 202,036 = 0.4

A) EXISTING: PER CITY CODE SECTION 10-1-1408

11,121 s.f. SHOWROOM 2.5 SPACES PER 1,000 S.F. OF AGFA = 3,093*2.5/1,000 = 8 SPACES 3 SPACES PER 1,000 S.F. OF AGFA = 8,028*3 /1,000 = 25 SPACES | PARTS/MISC. SERVICE: 3.3 SPACES PER 1,000 S.F. OF AGFA = (384+269)*3.3 / 1,000 = 3 SPACES 6,358 s.f. | SERVICE AREA: 3 SPACES PER SERVICE BAY (5,705 s.f.)= 3*11 = 33 SPACES DISPLAY AREA: 1 SPACE PER 2,000 S.F. OF OUTDOOR DISPLAY AREA = 58,000*1 /2,000 = 29 SPACES
TOTAL REQUIRED: 98 SPACES (PER TABLE 11B-208.2, 4 ACCESSIBLE SPACES ARE REQUIRED) 128 STANDARD SPACES (INCLUDING 5 ACCESSIBLE SPACES)

370 SALES INVENTORY SPACES TOTAL PROVIDED: 498 SPACES B) NEW PARKING STRUCTURE: 86 STANDARD SPACES 11 SPACES (8 AT 1ST FLOOR, 3 AT EXIST. DECK) TOTAL LOSS:

NET NEW ADDITIONAL: 75 STANDARD SPACES 573 SPACES NEW TOTAL:

EV STALLS: 98*0.06=5.88 => 6 EV STALLS REQUIRED AND PROVIDED PER CITY REQUIREMENTS. 5 EXISTING ACCESSIBLE PARKING SPACES (*) (*) OTHER THAN THE PARKING STRUCTURE, NO ADDITIONAL BUILDING AREA (ENCLOSED) IS BEING PROPOSED. NEW PARKING IS AN EXTRA ADDITION TO CITY REQUIREMENTS.

BUILDING DATA: TYPE OF CONSTRUCTION: II-B (EXISTING AND PROPOSED)

FIRE SPRINKLERS?: YES EXISTING OCCUPANCY: B, S-1, S-2 NEW BUILDING OCCUPANCY: S-2 ACTUAL BUILDING AREA:

B OCC.: EXISTING SHOWROOM=11,121 S.F. S-2 OCC.: EXISTING PARKING GARAGE=40,632 S.F. S-2 OCC.: NEW PROPOSED PARKING GARAGE=28,999 S.F B OCC.: EXISTING CARWASH=1,109 S.F.

S-1 OCC.: EXISTING SERVICE AREA=6,358 S.F. S-2 OCC.: EXISTING UPPER LEVEL= 34,844 S.F. ALLOWABLE AREA, TABLE 506.2 AND SEC. 506.2.4 B OCC = 69,000+(23,000*0.56)=81,880 S-1 OCC = 52,500+(17,500*0.56)=62,300

S-2 OCC = 78,000+(26,000*0.56)=92,560

PER SECTIONS 506.2.4 AND 508.4.2: 1ST FLOOR: Aa=11,121/81,880+(40,632+28,999)/92,560=0.89 < 1 OK 2ND FLOOR Aa=1,109/81,880+6,358/62,300+(34,844+28,999)/92,560=0.81 < 1 OK

SHEET INDEX


ARCHITECTURAL (CS COVER SHEET G001 CITY GENERAL NOTES G002 CITY GENERAL NOTES G003 CITY GENERAL NOTES A100 SITE PLAN {A110 EXISTING PARKING DISTRIBUTION PLAN{ \(\times \) { A150 SITE CIRCULATION PLAN A200 GROUND FLOOR PLAN A210 OVERALL PARKING DECK PLAN \$ A220 DECK FLOOR PLAN A300 ELEVATIONS A320 SECTIONS A400 PARKING 3D VIEW SITE PLAN

LANDSCAPE L-1 LANDSCAPE PLAN

REFERENCE ONLY (NOT PART OF SUBMITTAL) P6.0 DETAILS - PLUMBING (AS-BUILT)



Attachment 3

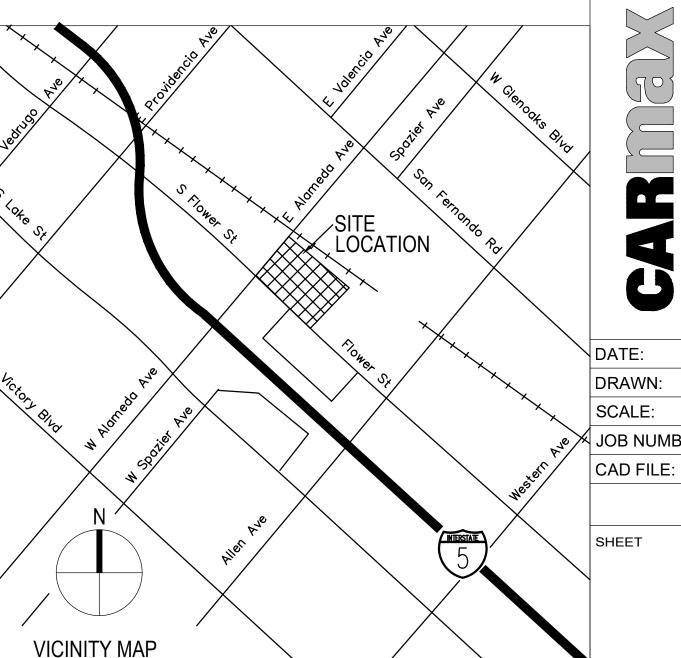


CALIFORNIA CORPORATE OFFICE 1570 LINDA VISTA DRIVE, SAN MARCOS, CALIFORNIA 92078


FOR ANY PURPOSE IS STRICTLY PROHIBITED WITHOUT PRIOR CONSENT FROM LUSARDI CONSTRUCTION COMPANY




No. Description Date Devep. Review 5/29/2020 Devep. Review 11/9/2020 Devep. Review

G:\CARMAX\Burbank, CA\2019 Burbank Parking **COVER SHEET**

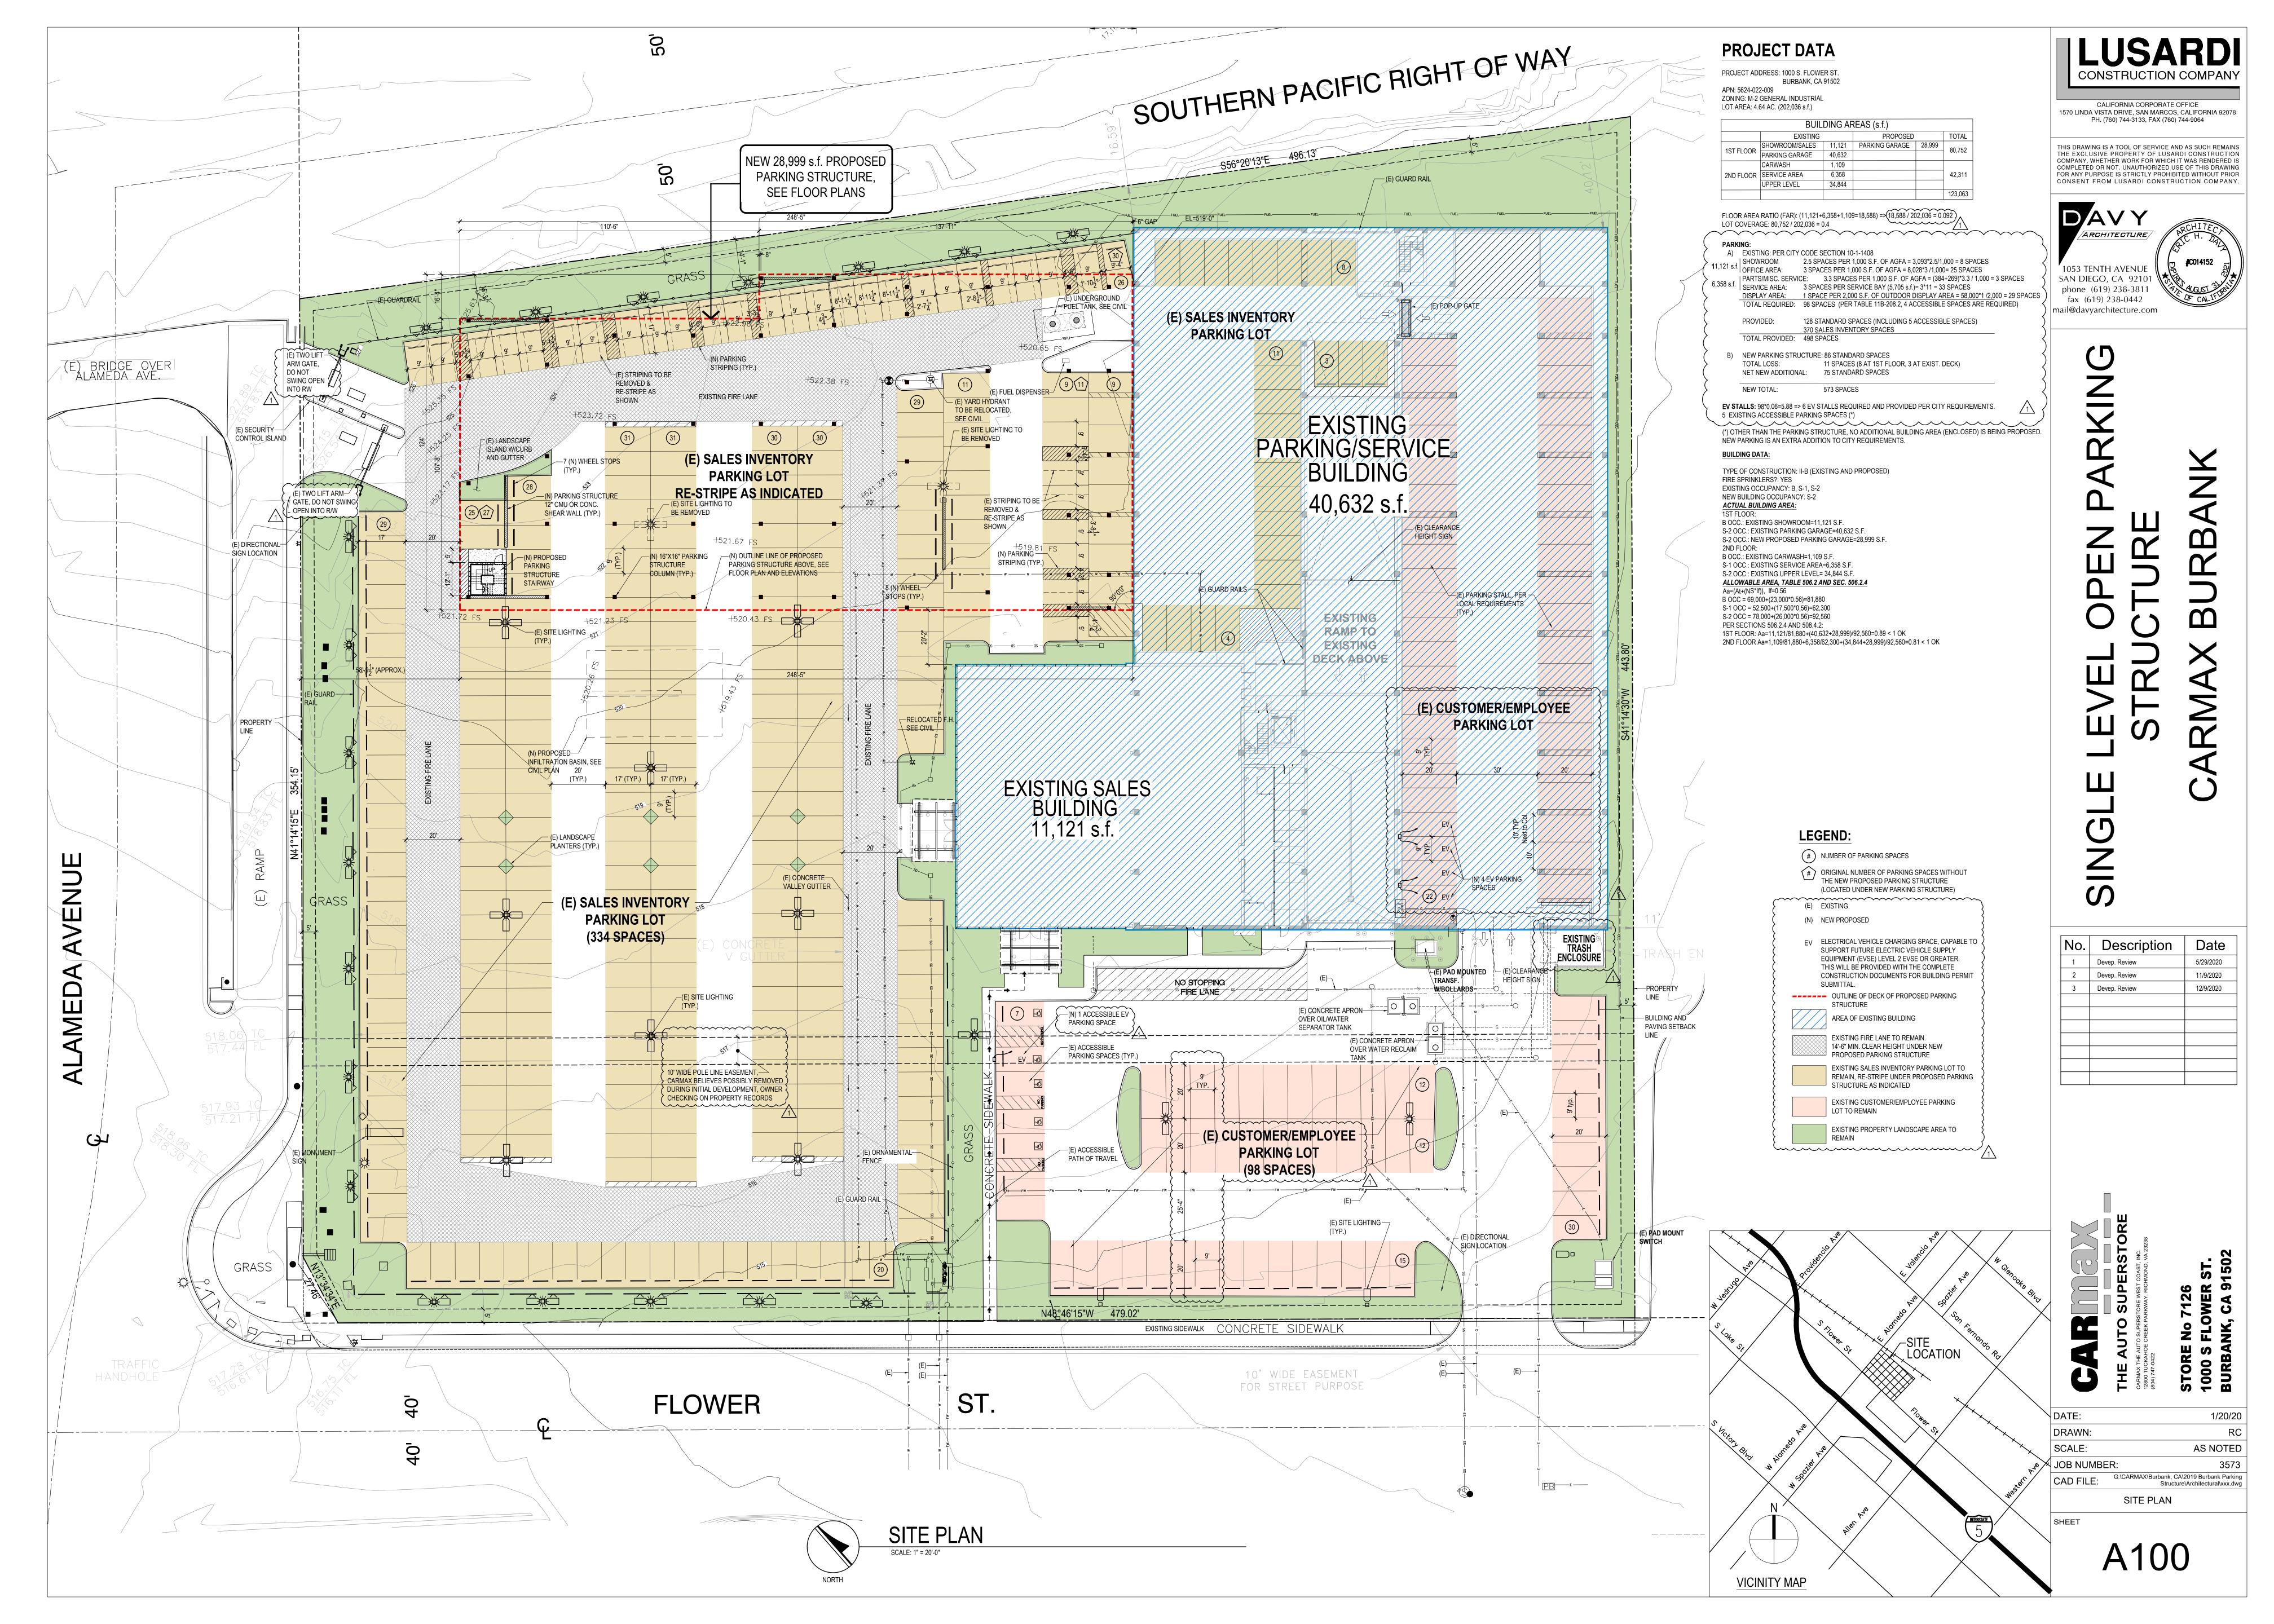

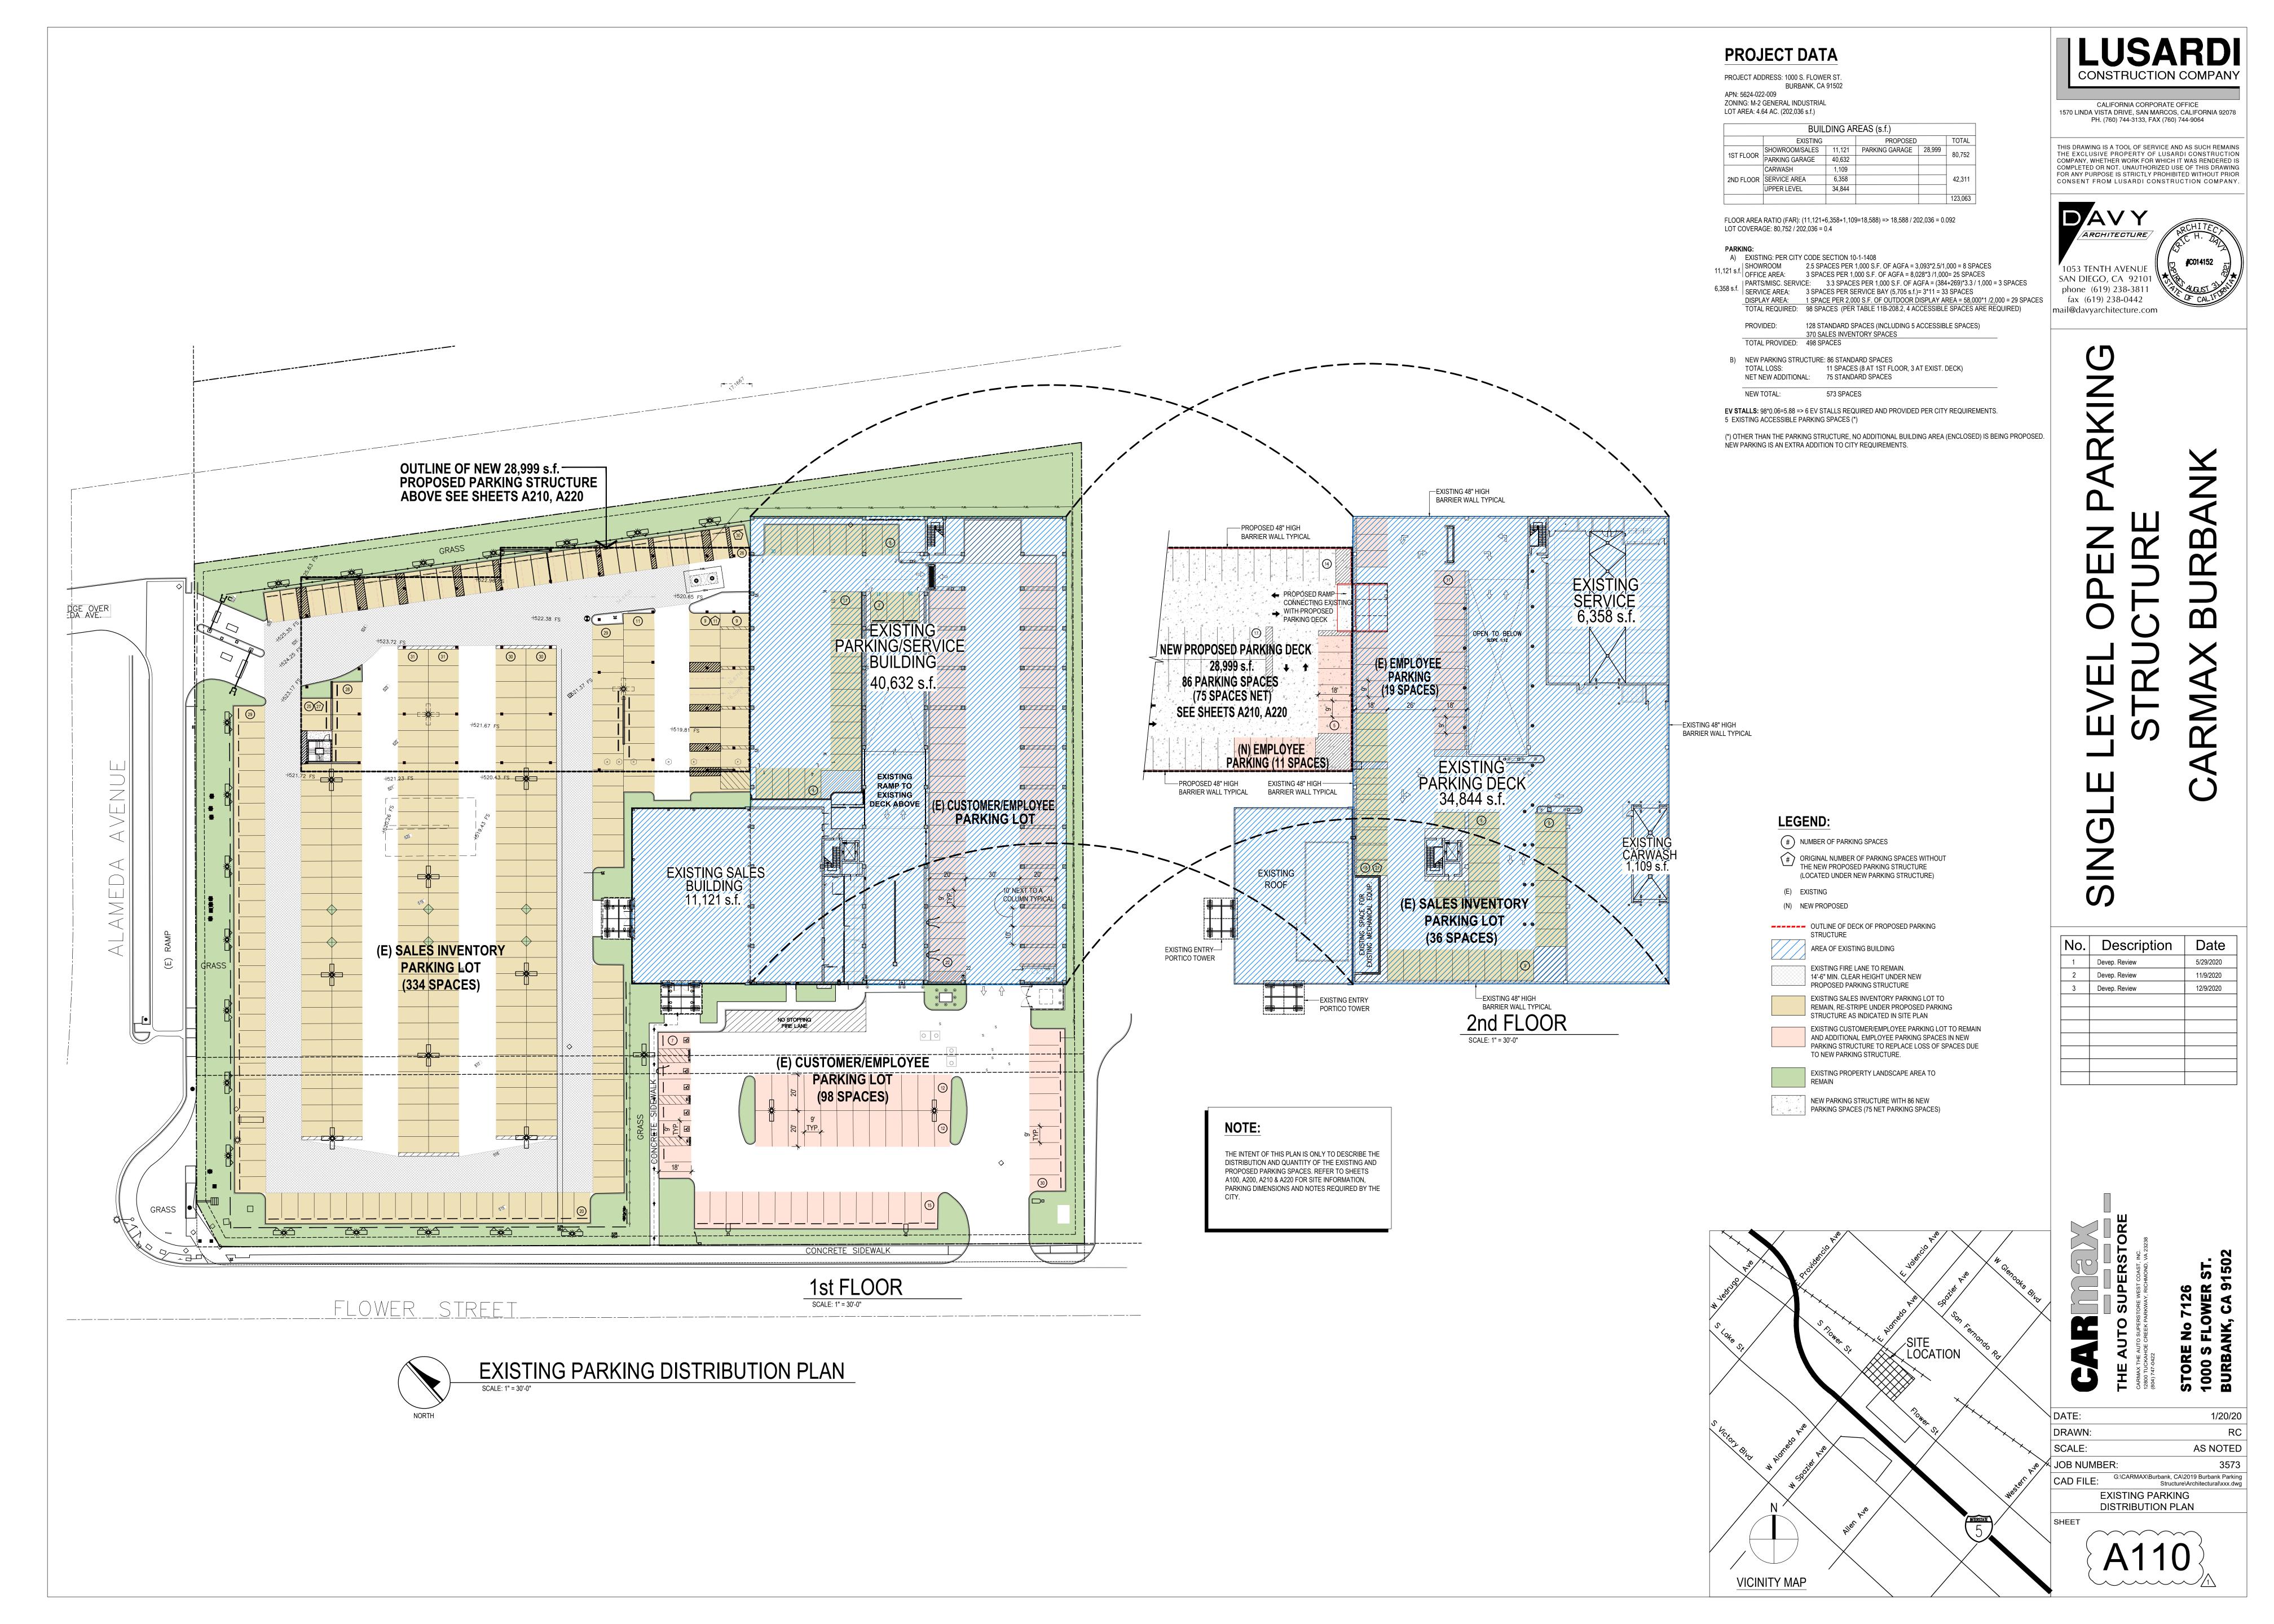



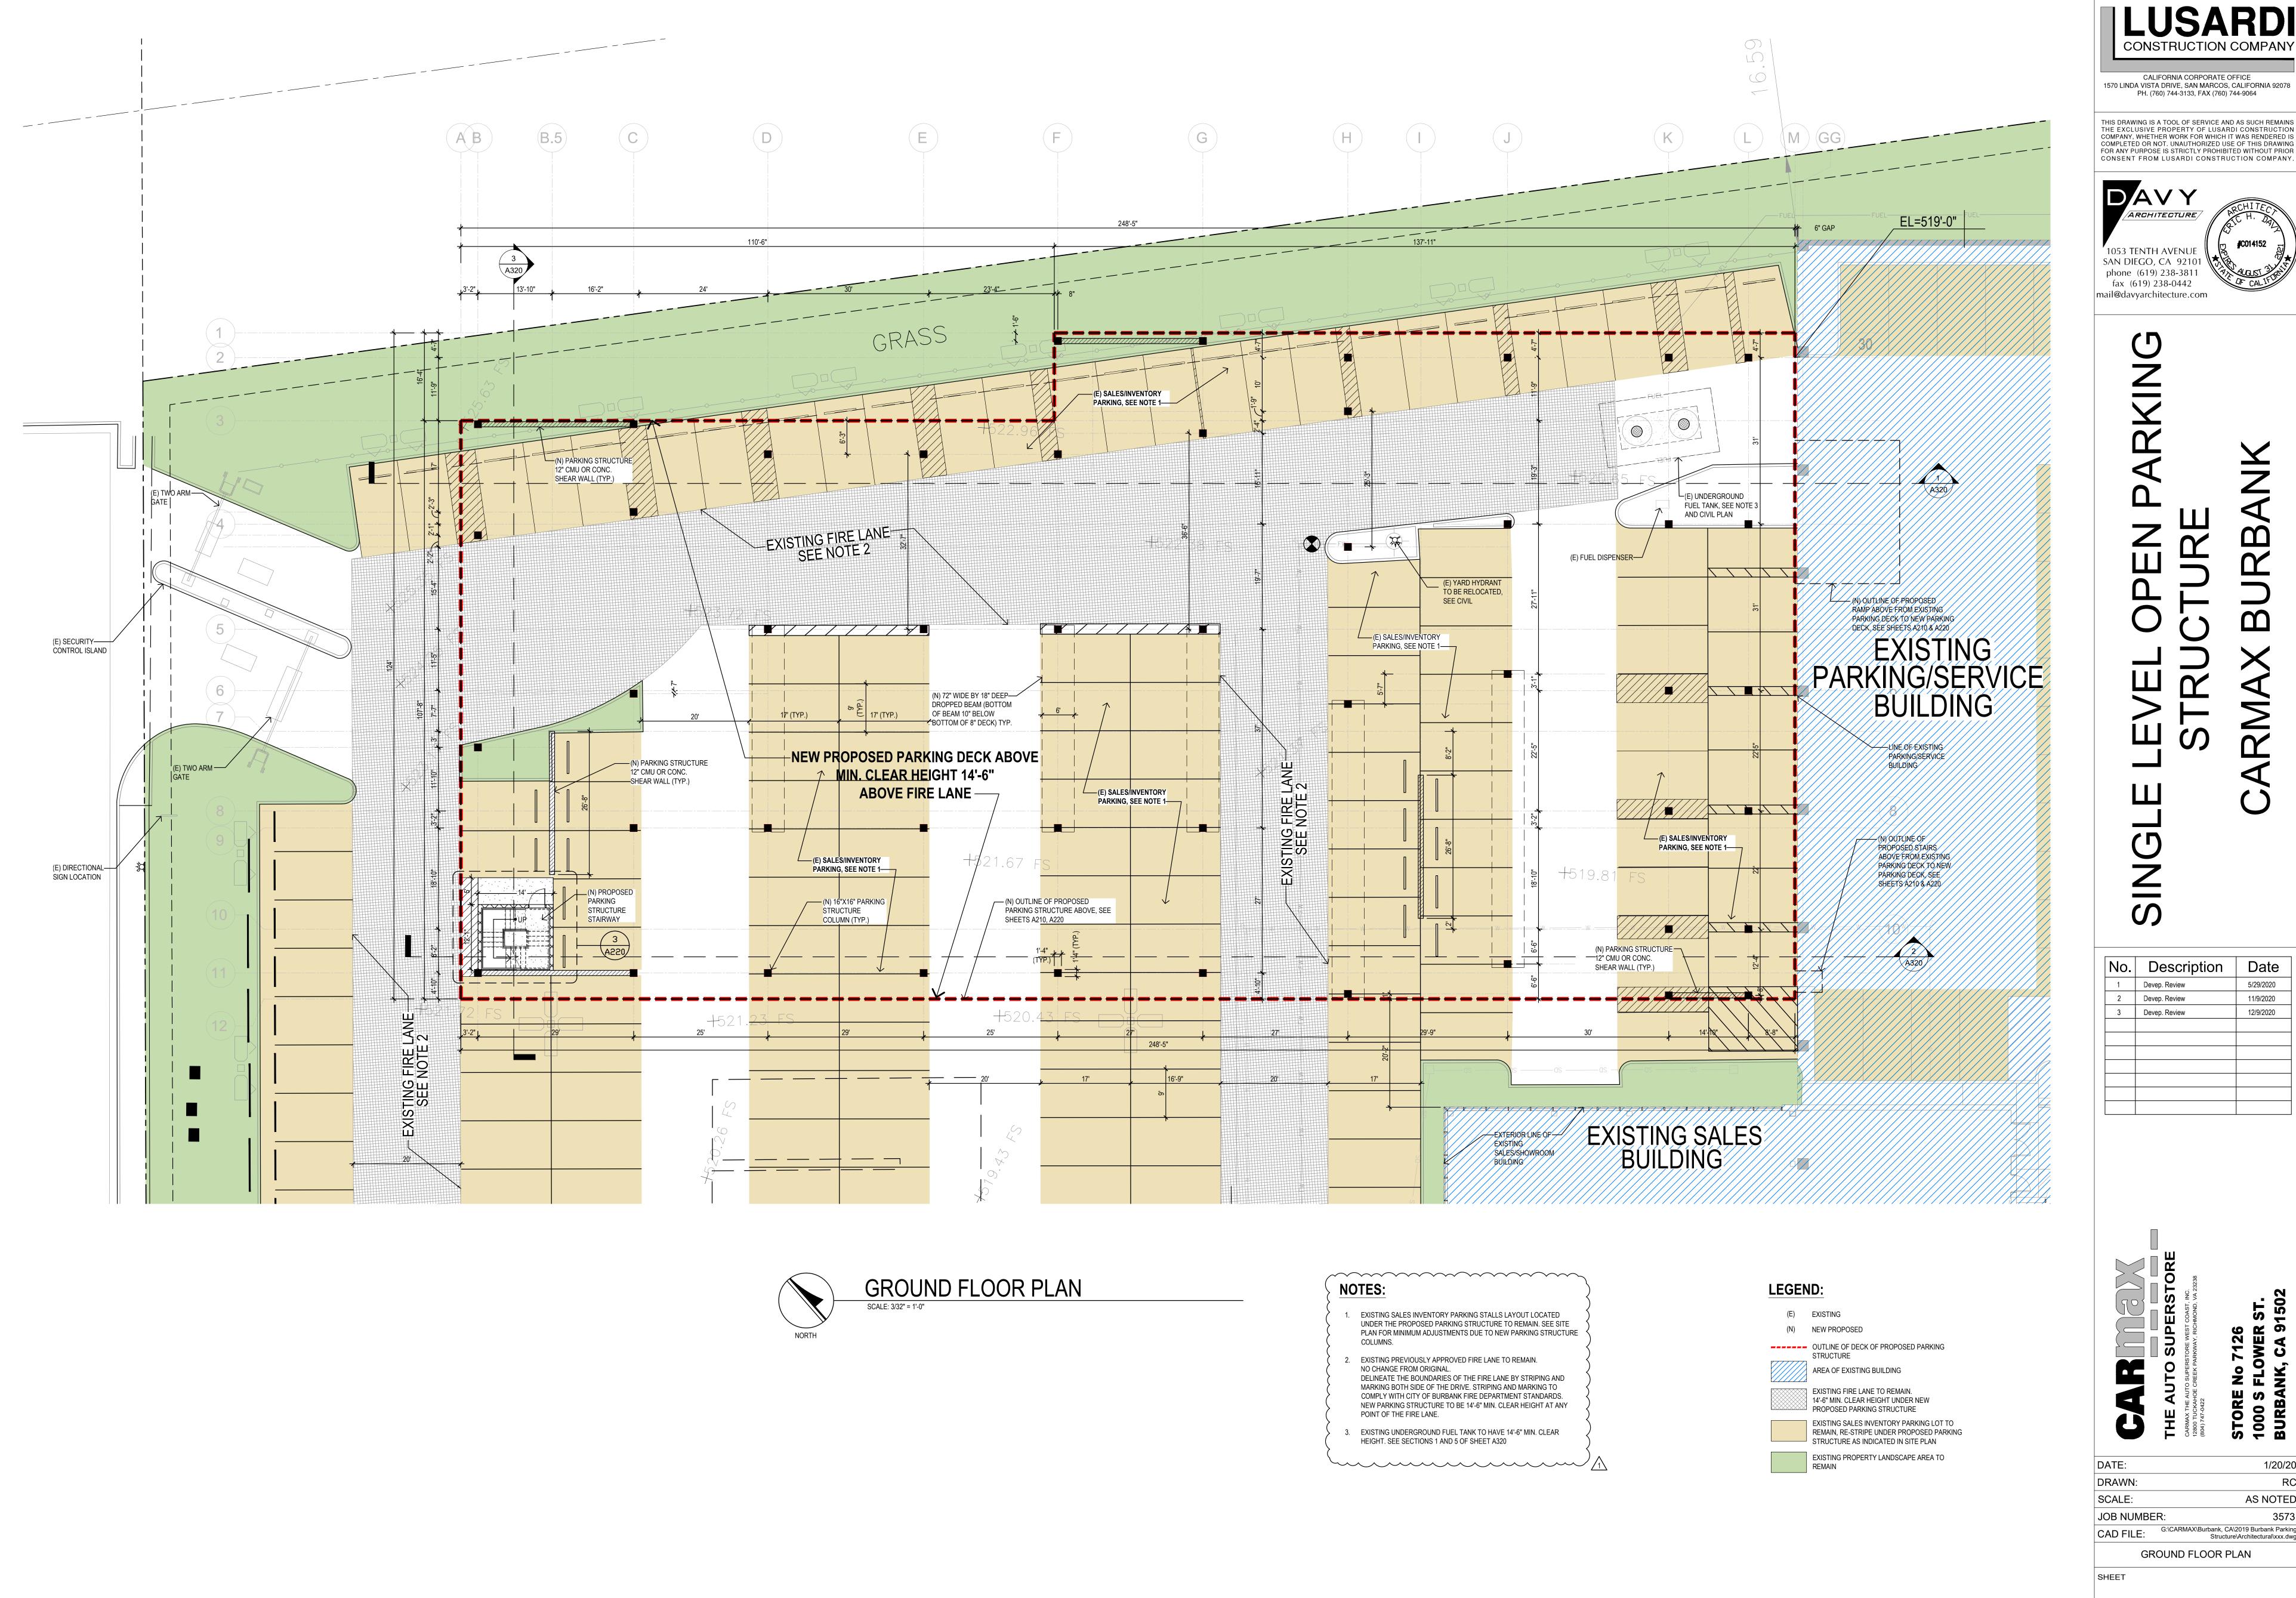



PH. (760) 744-3133, FAX (760) 744-9064




No.	Description	Date
1	Devep. Review	5/29/2020
2	Devep. Review	11/9/2020
3	Devep. Review	12/9/2020



THE AUTO SU	CARMAX THE AUTO SUPERSTORE W 12800 TUCKAHOE CREEK PARKWAY, (804) 747-0422	STORE No 712 1000 S FLOWE BURBANK, CA
		1/20/2
N:		R
•_		AC NOTE

AS NOTED JOB NUMBER: 3573 CAD FILE: G:\CARMAX\Burbank, CA\2019 Burbank Parking Structure\Architectural\xxx.dwg

GROUND FLOOR PLAN

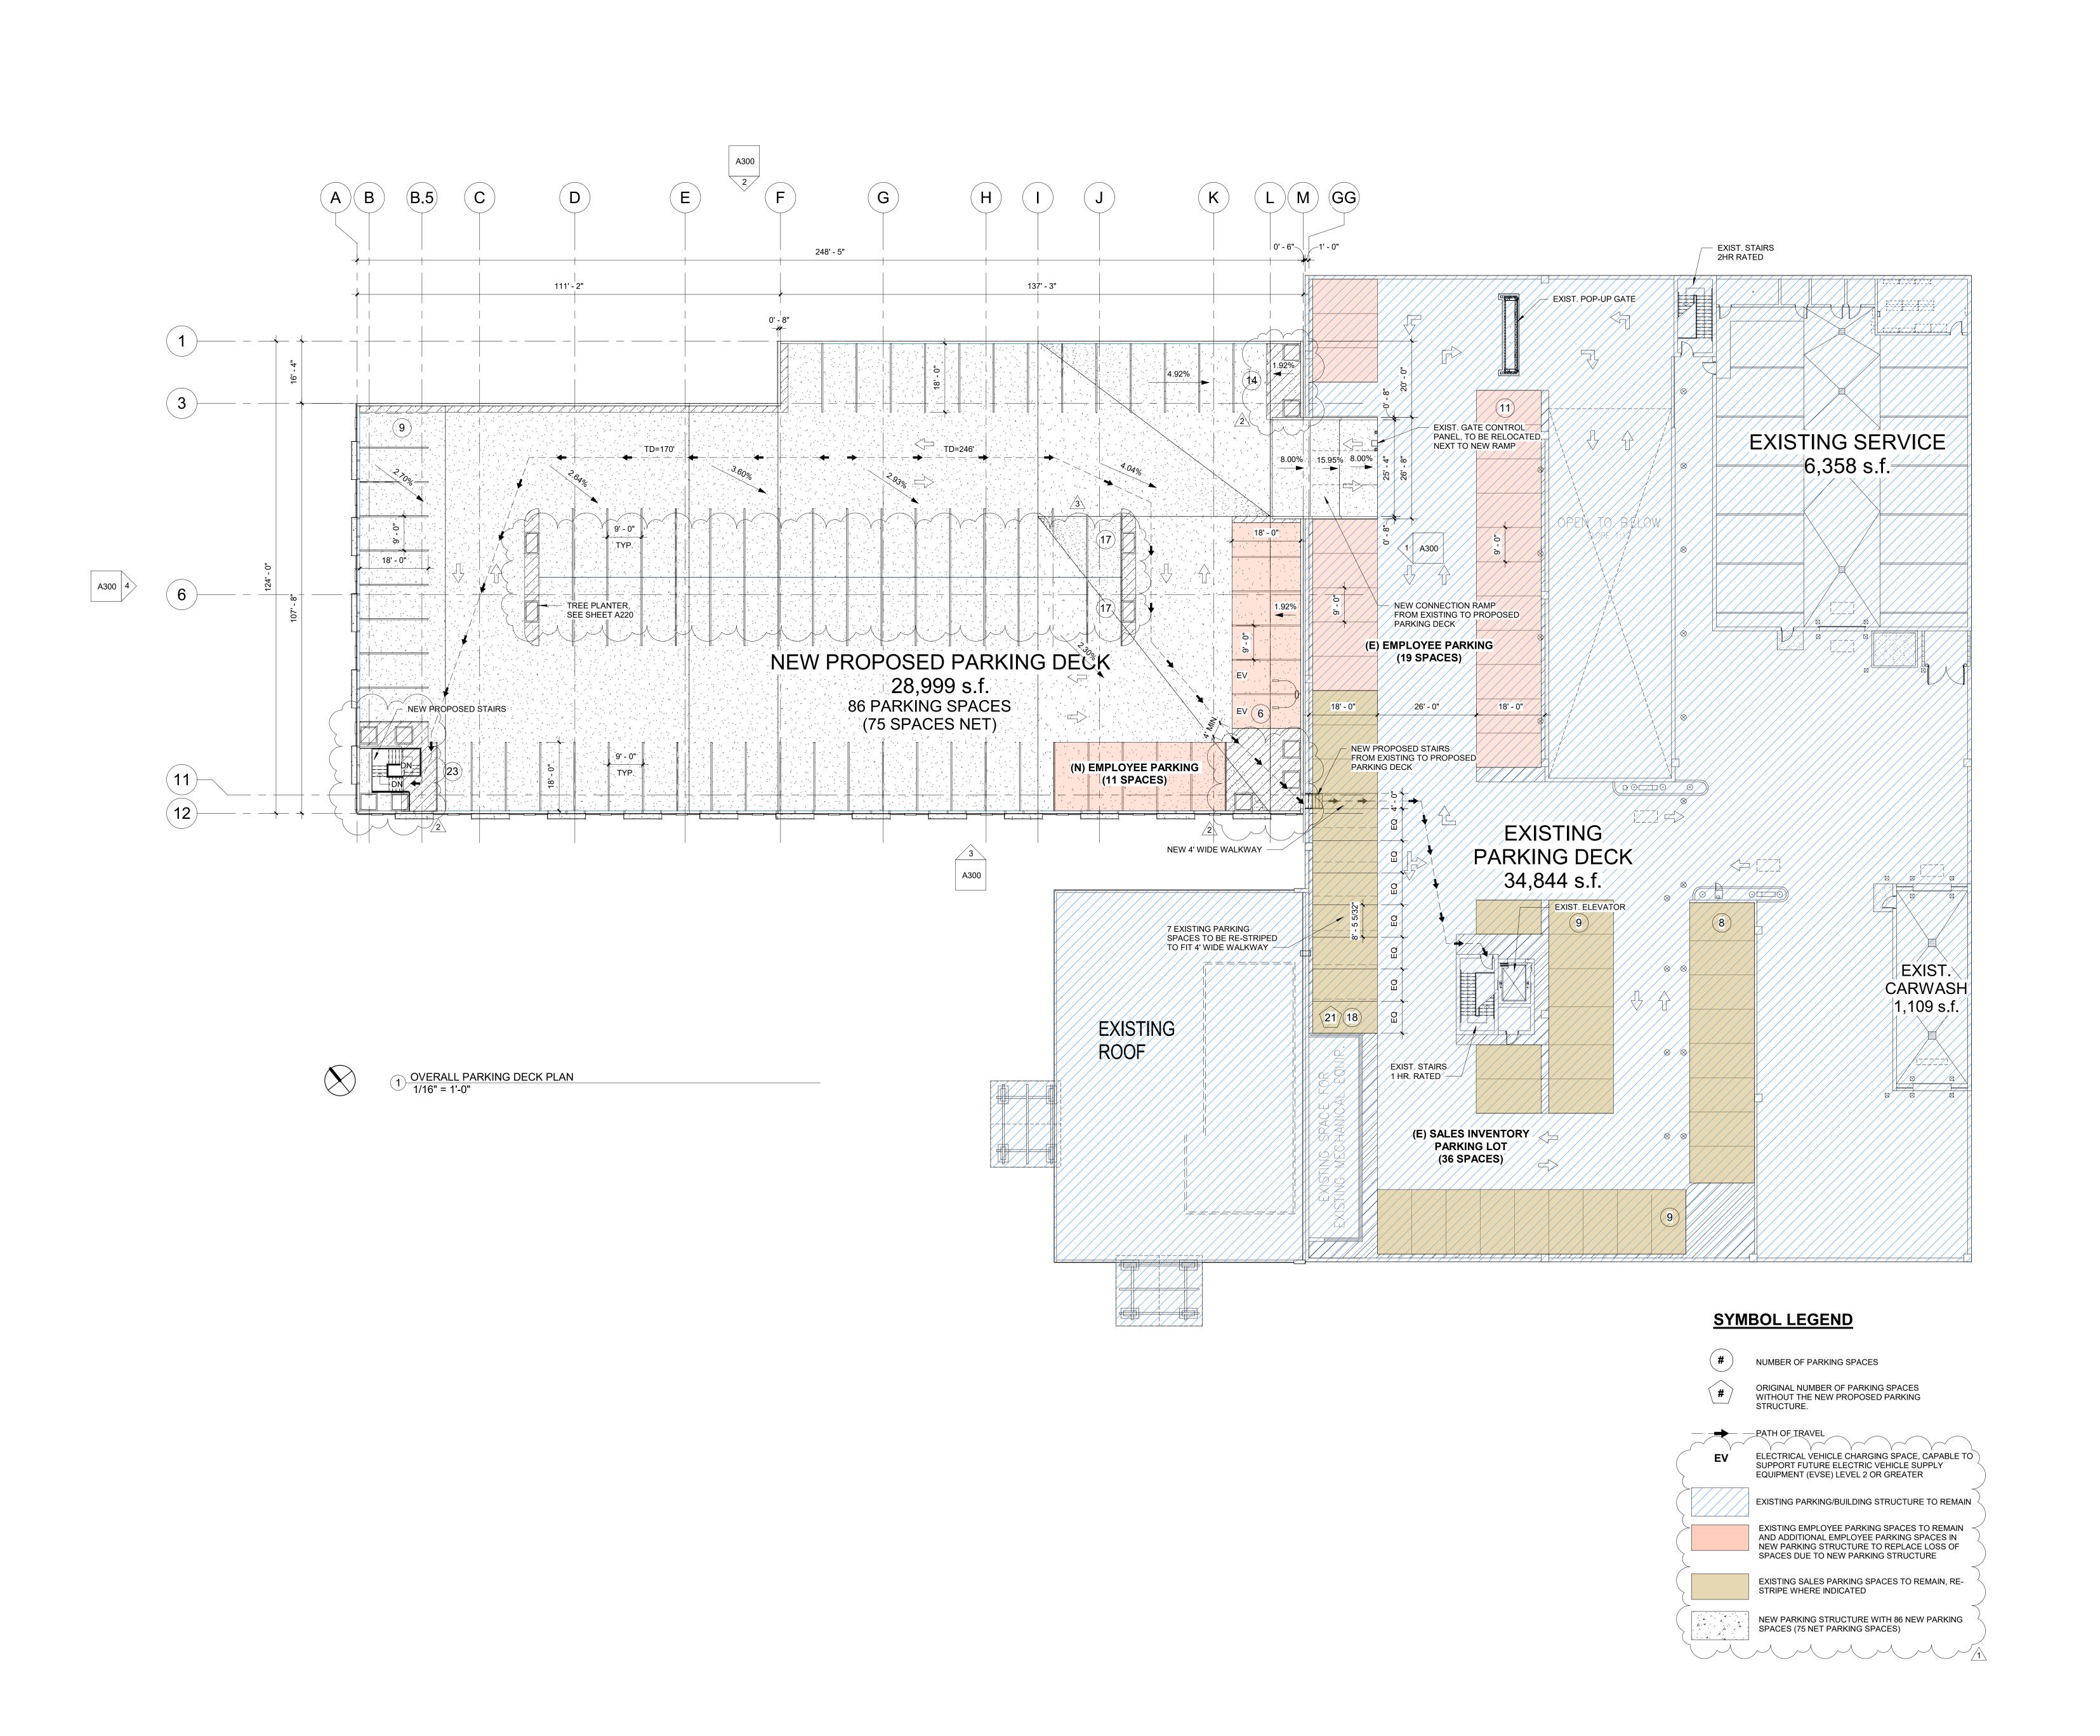



CALIFORNIA CORPORATE OFFICE 1570 LINDA VISTA DRIVE SAN MARCOS, CALIFORNIA 92078 PHONE (760)744-3133, FAX (760) 744-9064

THIS DRAWING IS A TOOL OF SERVICE AND AS SUCH REMAINS THE EXCLUSIVE PROPERTY OF LUSARDI CONSTRUCTION COMPANY, WHETHER WORK FOR WHICH IT WAS RENDERED IS COMPLETED OR NOT. UNAUTHORIZED USE OF THIS DRAWING FOR ANY PURPOSE IS STRICTLY PROHIBITED WITHOUT PRIOR CONSENT FROM LUSARDI CONSTRUCTION

NGLE LEVEL OPEN PARKIN STRUCTURE CARMAX BIRBANK

No.	Description	Da
1	Devep. Review	5/29/2
2	Devep. Review	11/9/2
3	Devep. Review	12/9/2



DATE: 1/20/20

DRAWN: RC

SCALE: As indicated


JOB NUMBER: 3573


CAD FILE: C:\LCC G Drive\CARMAX\Burbank, CA\2019
Burbank Parking Structure\Architectural\Burbank
Parking 12.9.20.rvt

OVERALL PARKING
DECK PLAN

SHEET

A210

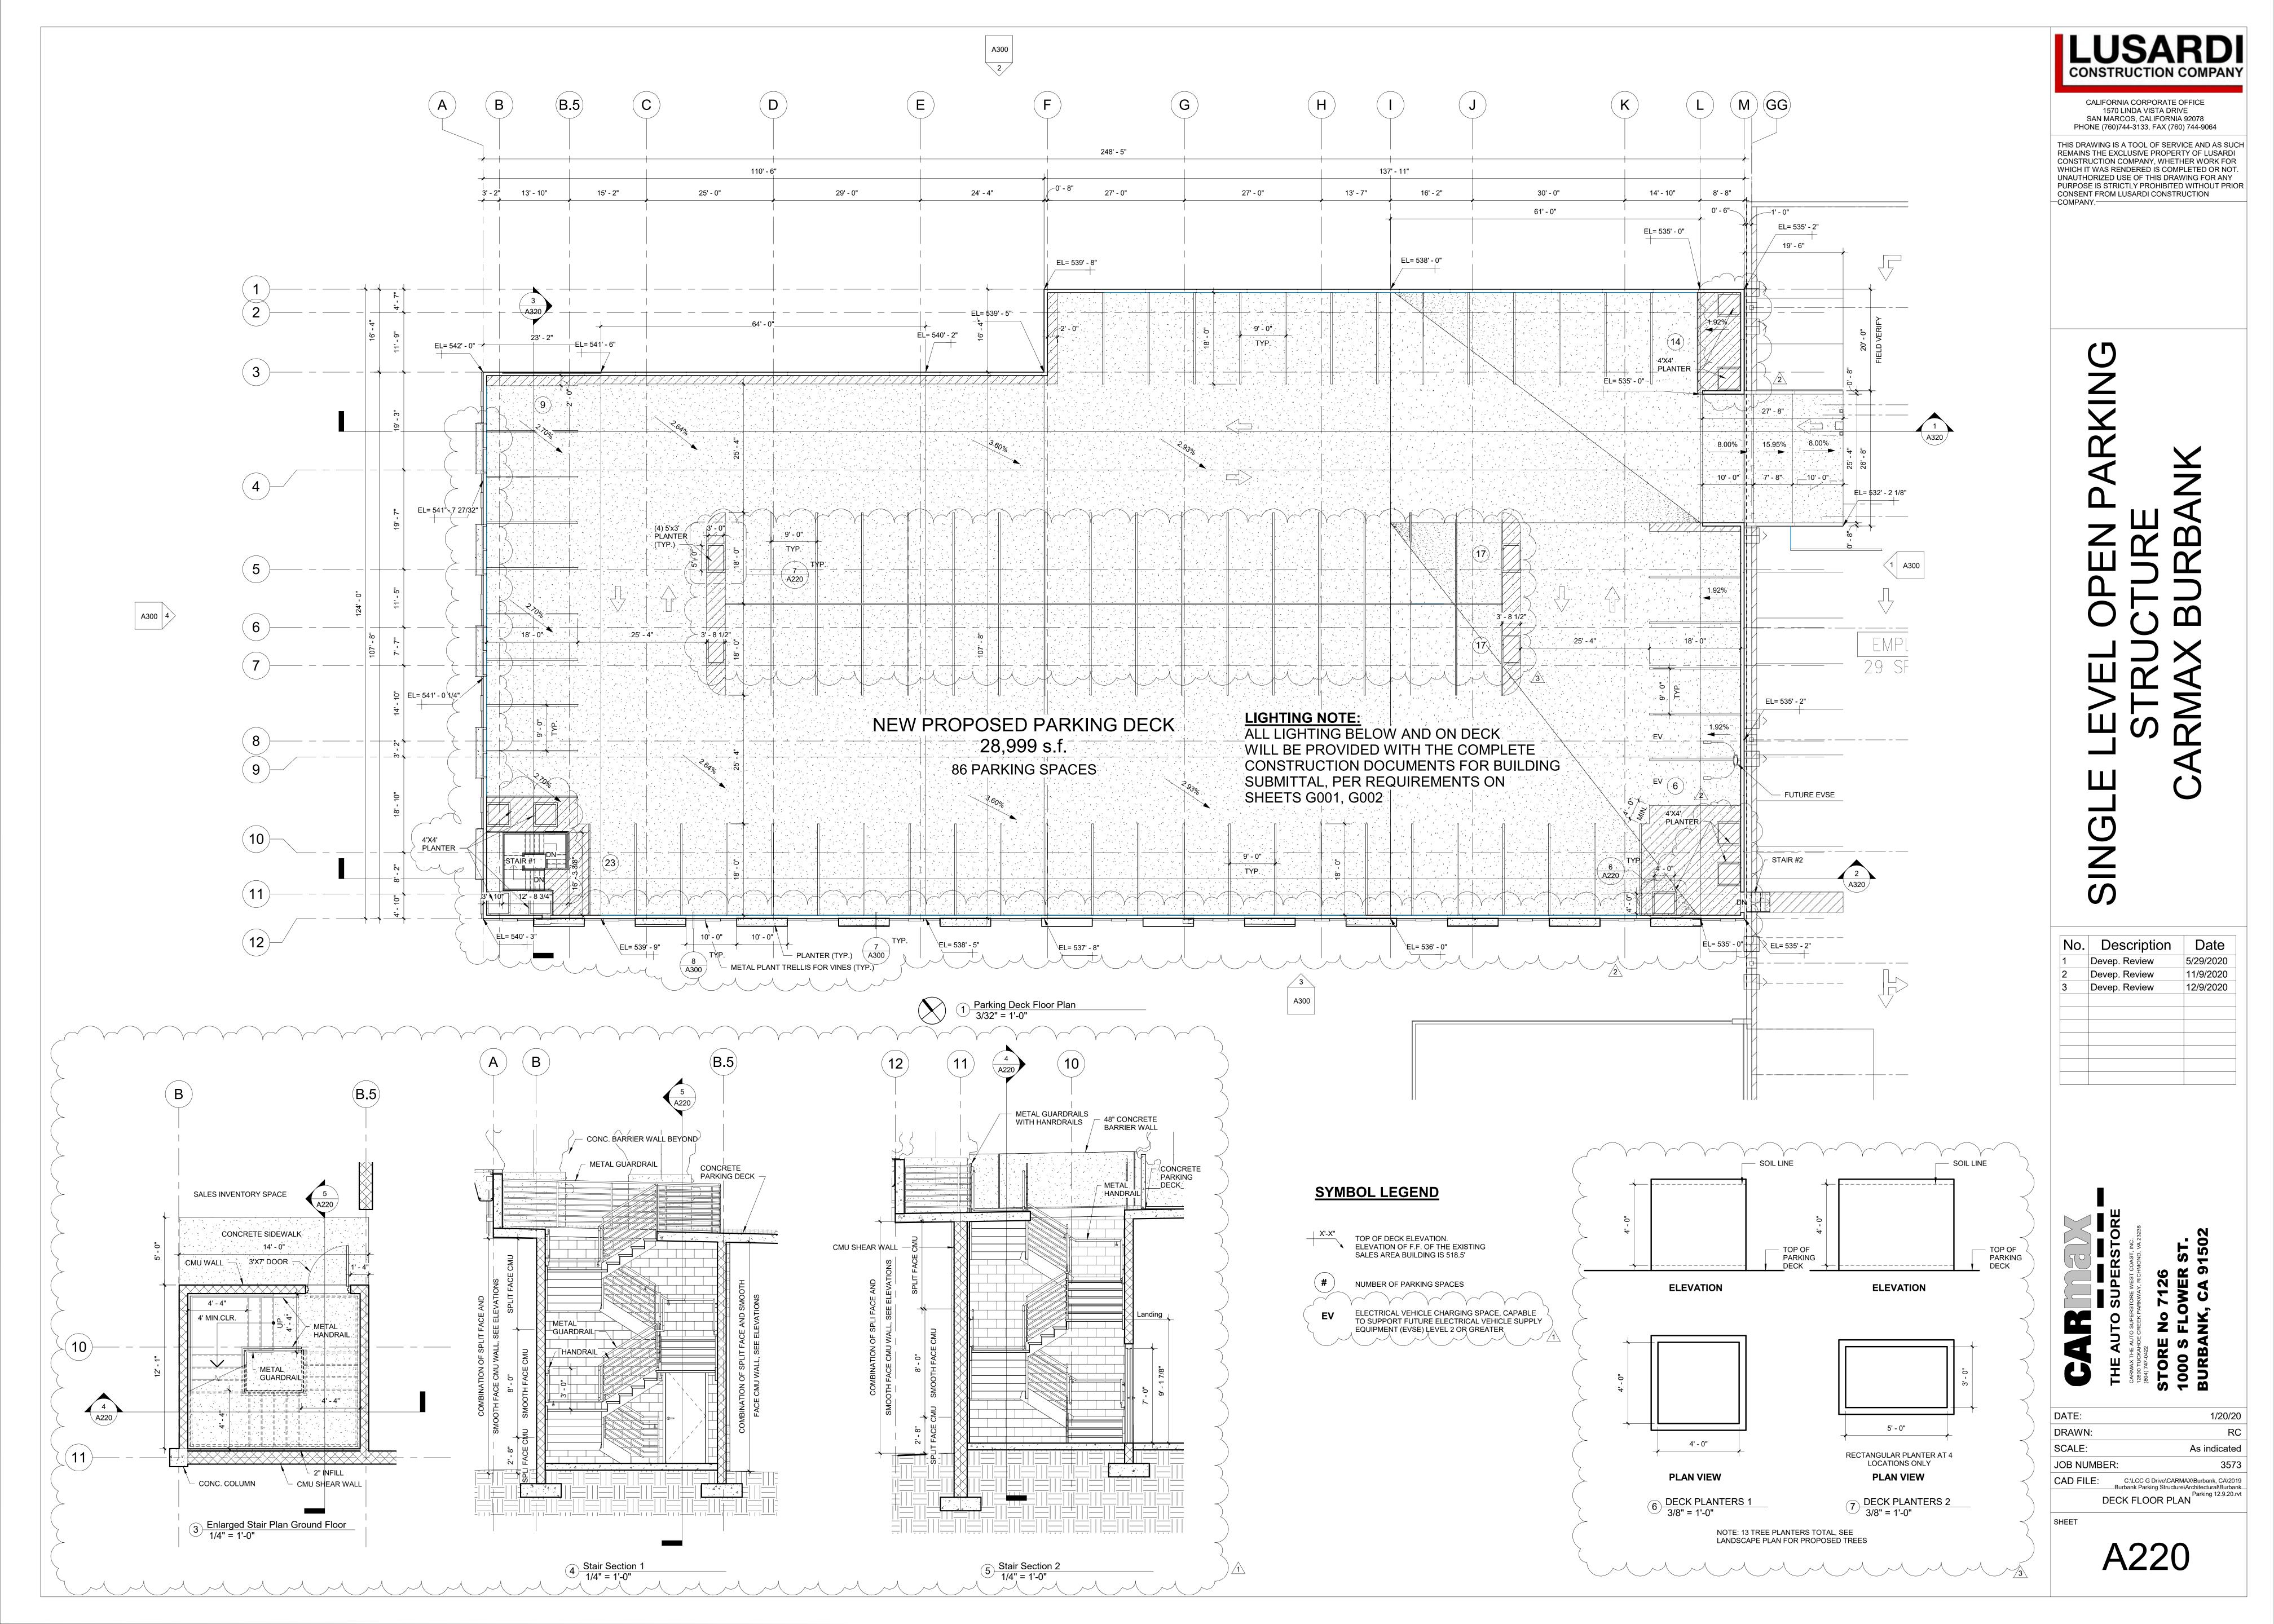

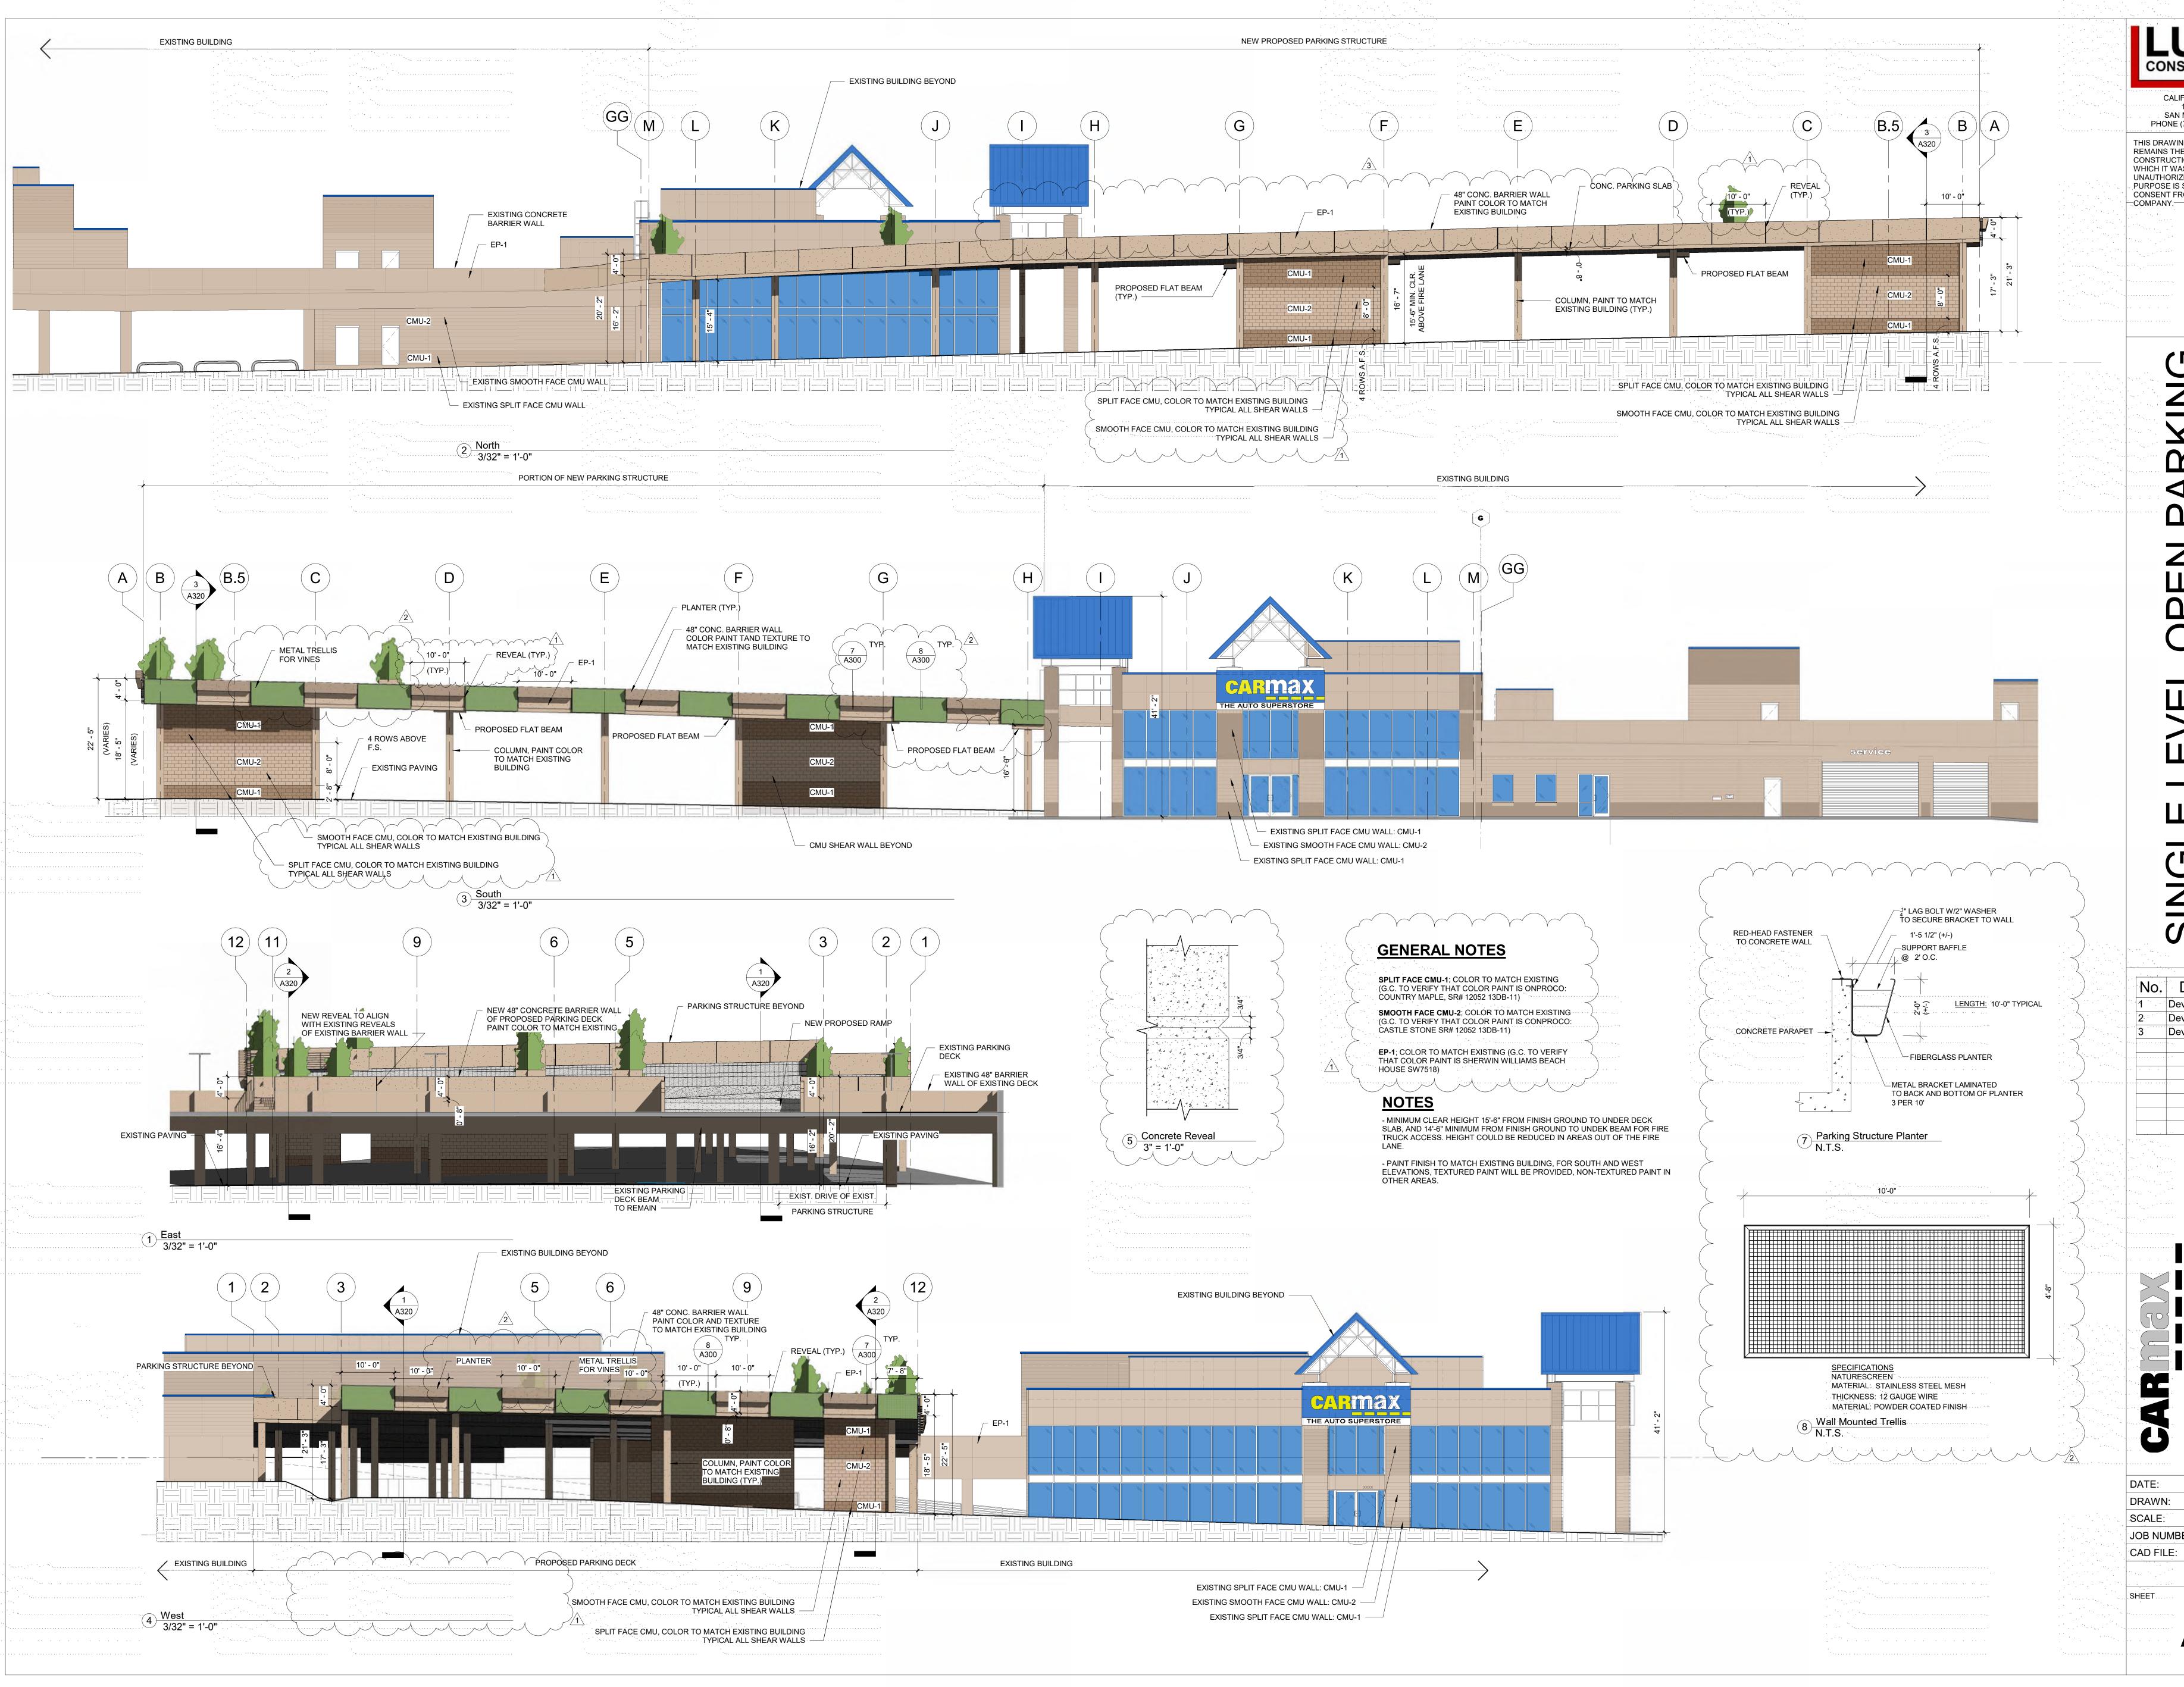

LUSARD CONSTRUCTION COMPAN

CALIFORNIA CORPORATE OFFICE 1570 LINDA VISTA DRIVE SAN MARCOS, CALIFORNIA 92078 PHONE (760)744-3133, FAX (760) 744-9064

THIS DRAWING IS A TOOL OF SERVICE AND AS SUCH REMAINS THE EXCLUSIVE PROPERTY OF LUSARDI CONSTRUCTION COMPANY, WHETHER WORK FOR WHICH IT WAS RENDERED IS COMPLETED OR NOT. UNAUTHORIZED USE OF THIS DRAWING FOR ANY PURPOSE IS STRICTLY PROHIBITED WITHOUT PRIOR CONSENT FROM LUSARDI CONSTRUCTION

SINGLE LEVEL OPEN PARKING
STRUCTURE
STRUCTURE

No. Description Date

1 Devep Review 5/29/2020
2 Devep Review 11/9/2020
3 Devep Review 12/9/2020

THE AUTO SUPERSTORE

CARMAX THE AUTO SUPERSTORE WEST COAST, INC.
12800 TUCKAHOE CREEK PARKWAY, RICHMOND, VA 23238
(804) 747-0422

STORE No 7126

1000 S FLOWER ST.

DATE: 1/20/20

DRAWN: RC


SCALE: As indicated

JOB NUMBER: 3573

CAD FILE: C:\LCC G Drive\CARMAX\Burbank, CA\2019
Burbank Parking Structure\Architectural\Burbank
Parking 12.9.20.rvt

ELEVATIONS

A300

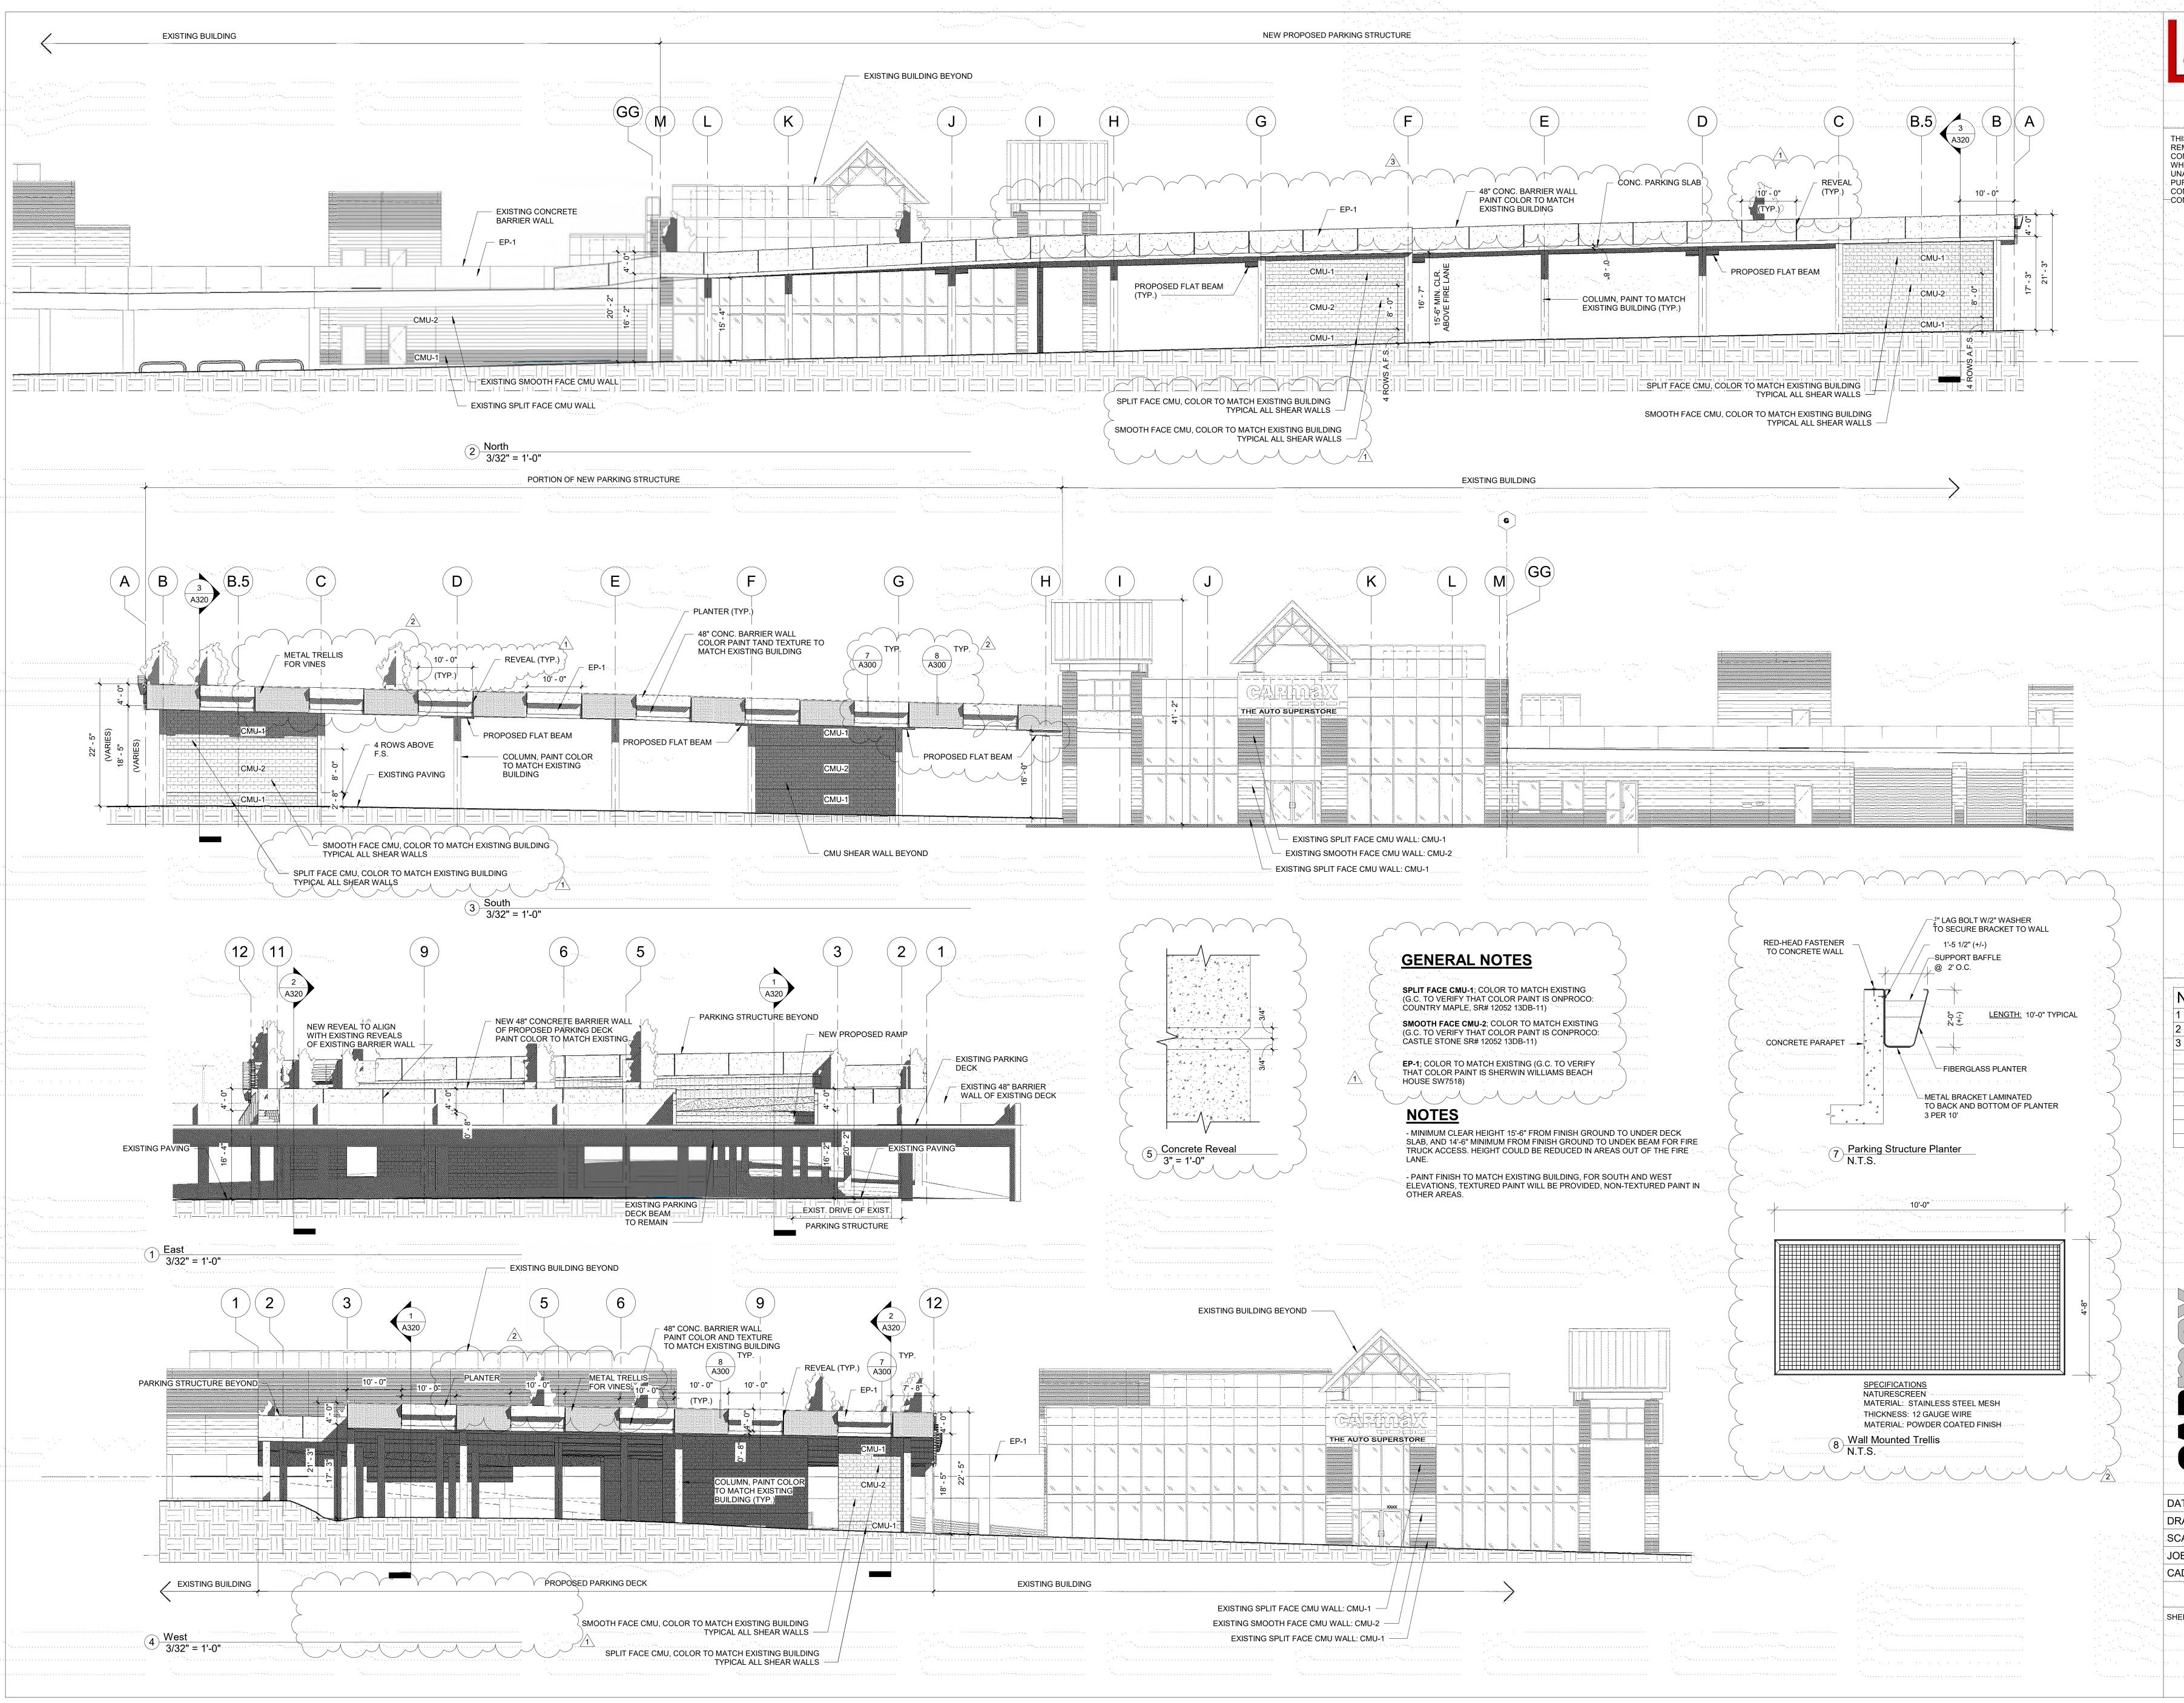

LUSARDI CONSTRUCTION COMPANY

CALIFORNIA CORPORATE OFFICE 1570 LINDA VISTA DRIVE SAN MARCOS, CALIFORNIA 92078 PHONE (760)744-3133, FAX (760) 744-9064

THIS DRAWING IS A TOOL OF SERVICE AND AS SUCH REMAINS THE EXCLUSIVE PROPERTY OF LUSARDI CONSTRUCTION COMPANY, WHETHER WORK FOR WHICH IT WAS RENDERED IS COMPLETED OR NOT. UNAUTHORIZED USE OF THIS DRAWING FOR ANY PURPOSE IS STRICTLY PROHIBITED WITHOUT PRIOR CONSENT FROM LUSARDI CONSTRUCTION

SINGLE LEVEL OPEN PARKING STRUCTURE STRUCTURE

	No.	Description	Date
1	1	Devep. Review	5/29/2020
1	2	Devep. Review	11/9/2020
	3	Devep. Review	12/9/2020
٠			

THE AUTO SUPERSTORE


CARMAX THE AUTO SUPERSTORE WEST COAST, INC.
12800 TUCKÁHOE CREEK PARKWAY, RICHMOND, VA 23238
(804) 747-0422


STORE NO 7126


1000 S FLOWER ST.

DATE:	1/20/20
DRAWN:	RC
SCALE:	As indicated
JOB NUMBE	ER: 3573
CAD FILE:	C:\LCC G Drive\CARMAX\Burbank, CA\2019 —Burbank Parking Structure\Architectural\Burbank
	ELEVATIONS Parking 12.9.20.rvt
SHEET	


A300

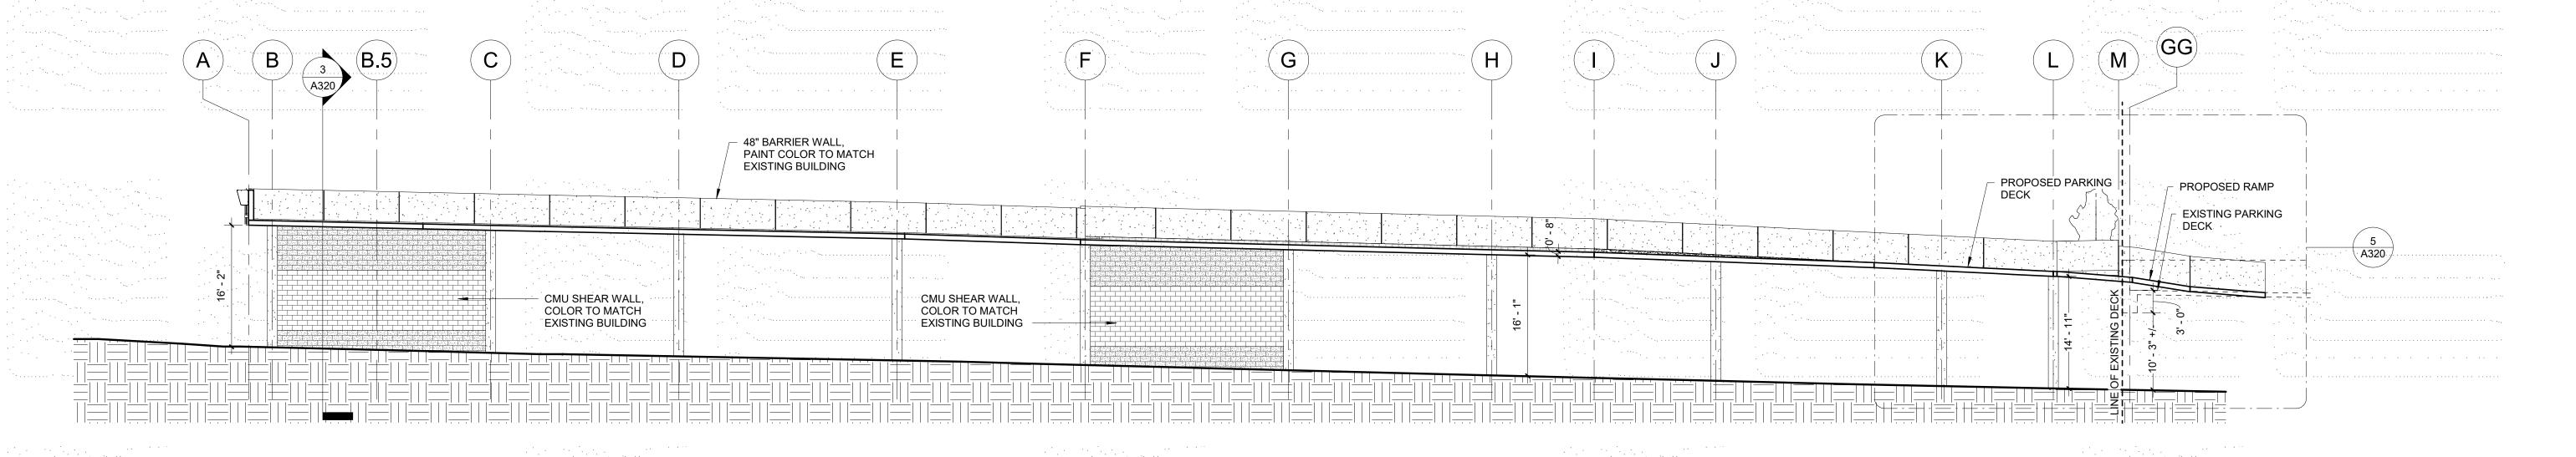


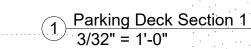

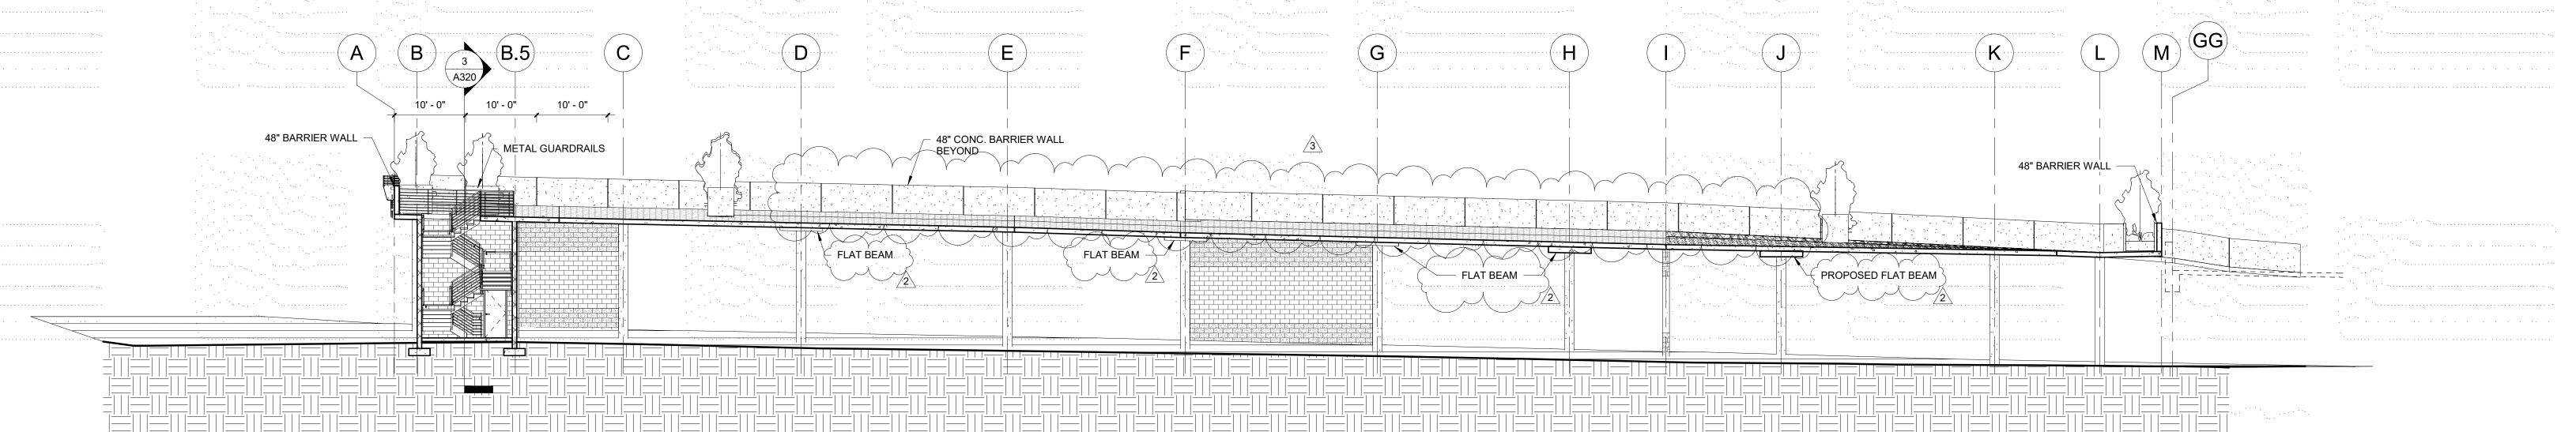


Paking Deck Section 2

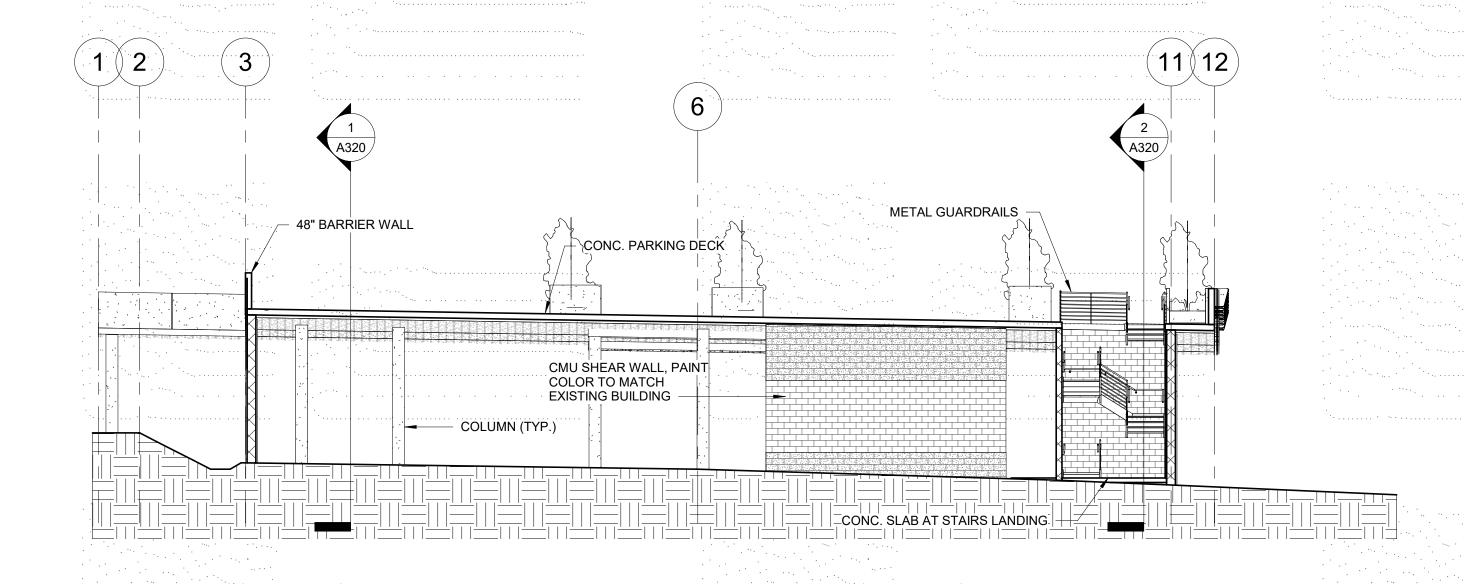

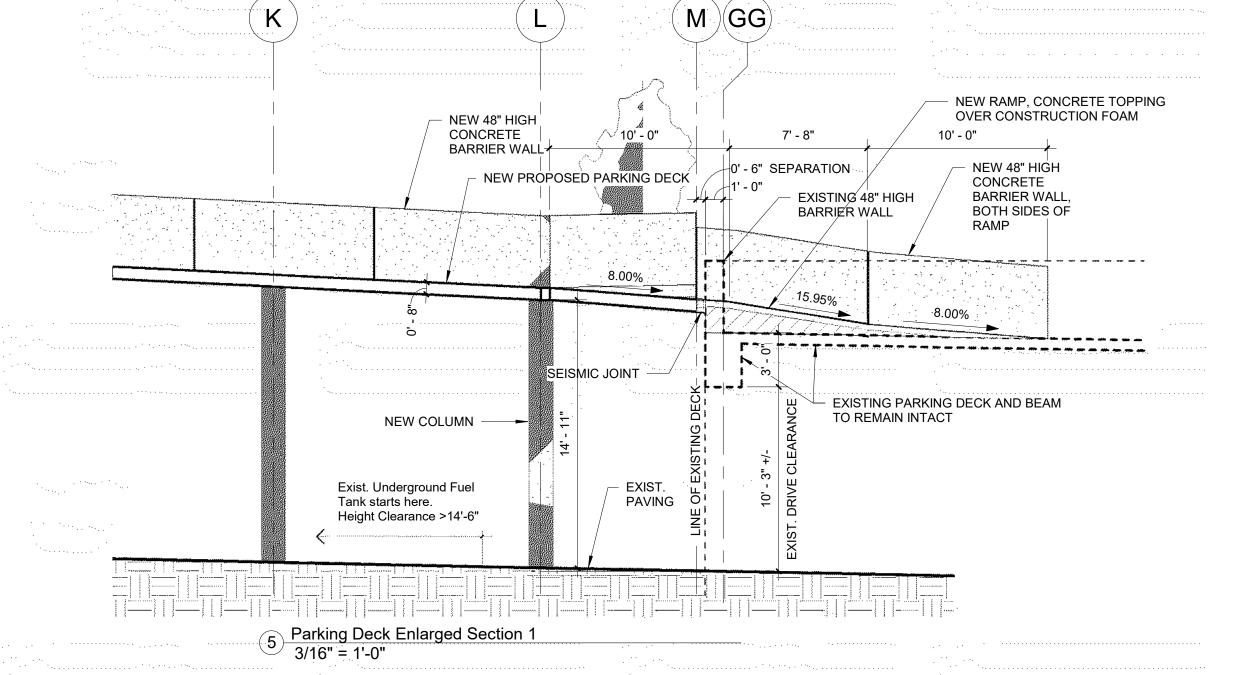


Parking Deck Section 3 3/32" = 1'-0"

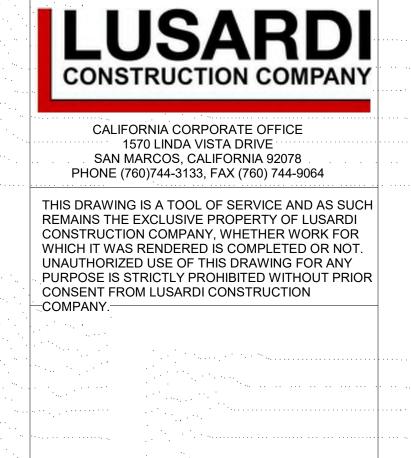

SINGLE LEVEL OPEN PARKING STRUCTURE STRUCTURE

	No.	Description	Date
	1	Devep. Review	5/29/2020
	2	Devep. Review	11/9/2020
· · · · · · · · ·	3	Devep. Review	12/9/2020

·· .			

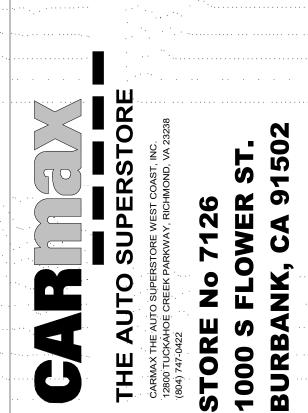

DATE:	1/20/
DRAWN:	
SCALE:	As indicat
JOB NUMBER	
CAD FILE:	C:\LCC G Drive\CARMAX\Burbank, CA\2 _Burbank Parking Structure\Architectural\Burl Parking 12.9.2 SECTIONS
SHEET	



CALIFORNIA CORPORATE OFFICE 1570 LINDA VISTA DRIVE SAN MARCOS, CALIFORNIA 92078 PHONE (760)744-3133, FAX (760) 744-9064

THIS DRAWING IS A TOOL OF SERVICE AND AS SUCH REMAINS THE EXCLUSIVE PROPERTY OF LUSARDI CONSTRUCTION COMPANY, WHETHER WORK FOR WHICH IT WAS RENDERED IS COMPLETED OR NOT. UNAUTHORIZED USE OF THIS DRAWING FOR ANY PURPOSE IS STRICTLY PROHIBITED WITHOUT PRIOR CONSENT FROM LUSARDI CONSTRUCTION

No.	Description	Date
2	Devep. Review	11/9/2020
3	Devep. Review	12/9/2020

THE / CARMAX THE 12800 TUCKA (804) 747-042 STOR 1000 BURB DATE: 1/20/20 DRAWN: SCALE: 3573 JOB NUMBER: CAD FILE:

C:\LCC G Drive\CARMAX\Burbank, CA\2019
Burbank Parking Structure\Architectural\Burbank
Parking 12.9.20.rvt

Parking 3D View

